



GENERAL NOTES


- A LAND SURVEY HAS NOT BEEN PROVIDED. EXISTING SITE CONDITIONS INDICATED HEREIN ARE DIAGRAMMATIC ONLY AND PROVIDED FOR GENERAL REFERENCE.
- SITE DIMENSIONS TO FACE OF BUILDING, SIDEWALK, CURB GUTTER LINE, PROPERTY LINE, OR CENTER LINE OF STRIPING UNLESS OTHERWISE NOTED.
- EXISTING CONSTRUCTION TO REMAIN TO BE PROTECTED AS REQUIRED. REPLACE AND/OR REPAIR EXISTING CONSTRUCTION DAMAGED DUE TO CONTRACTOR ACTIVITIES.
- ALL DEMOLITION MATERIALS SHALL BECOME PROPERTY OF CONTRACTOR FOR PROPER DISPOSAL UNLESS OTHERWISE NOTED.
- PROVIDE SMOOTH ELEVATION AND GRADING TRANSITIONS FROM NEW CONSTRUCTION TO EXISTING CONSTRUCTION TO REMAIN.
- CONTRACTOR TO ENSURE EXISTING LANDSCAPING IS FREE OF WEEDS, FREE OF OVERGROWTH AND IS WELL MANICURED.

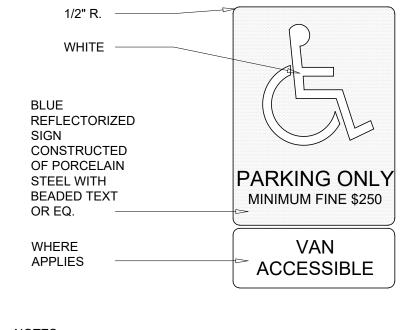

NOTES:

1. AREA OF SYMBOL SHALL BE 70 SQ. IN. MIN.
2. SIGN SHALL BE PLACED IN FRONT OF EACH ACCESSIBLE PARKING STALL, WITHIN CLEAR VIEW, BUT NOT PLACED SO AS TO OBSTRUCT PASSAGE FROM ANY PARKING STALL OR WALKWAY.

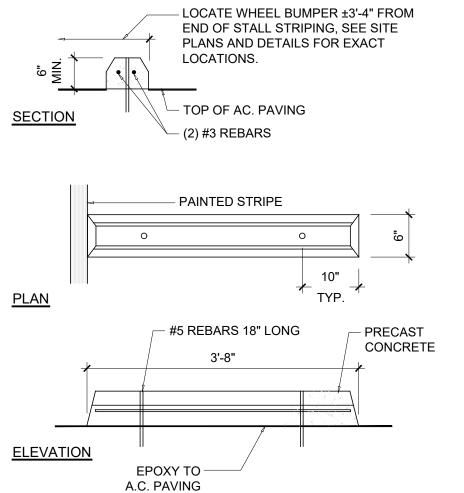

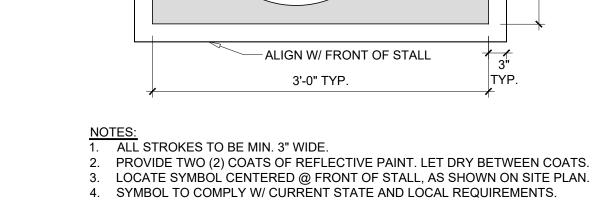

12 INTERNATIONAL ACCESSIBILITY SYMBOL SCALE: NTS

-BORDER &

WHITE

SYMBOL; PAINT

AN ENVIRONMENTAL ANALYSIS HAS NOT BEEN PERFORMED ON THE EXISTING SITE.

IF THIS PROJECT CONTAINS HAZARDOUS MATERIALS, CONTRACTOR TO PROVIDE WORK REQUIRED FOR PROPER REMOVAL, HANDLING, AND DISPOSAL PER ENVIRONMENTAL ANALYSIS RECOMMENDATIONS.



Know what's **below. Call** before you dig.

CAUTION: INFORMATION ON THIS DRAWING CONCERNING TYPE AND LOCATION OF UNDERGROUND AND OTHER UTILITIES IS NOT GUARANTEED TO BE ACCURATE OR ALL INCLUSIVE. THE CONTRACTOR IS RESPONSIBLE FOR MAKING HIS OWN DETERMINATION AS TO THE TYPE AND LOCATION OF UNDERGROUND AND OTHER UTILITIES AS MAY BE NECESSARY TO AVOID DAMAGE THERETO.

CONSTRUCTION OR PERMIT


Reilly

FOR REVIEW XX.XX.X 03/06/2025 ADD 01


01/27/25 PROJECT NUMBER: 24308

ACCESSIBLE PARKING SIGN


9 WHEEL STOP

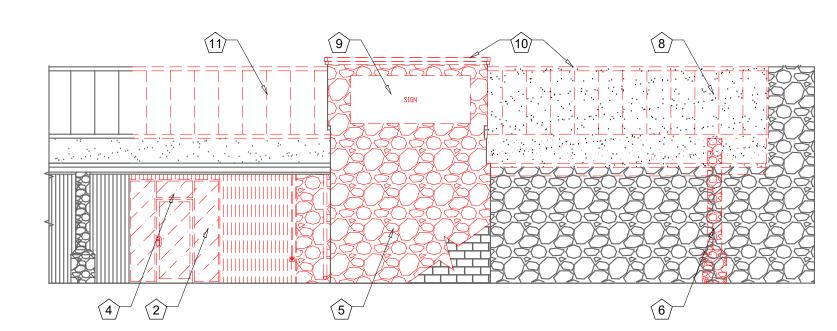

FRONT EXTERIOR DEMOLITION ELEVATION

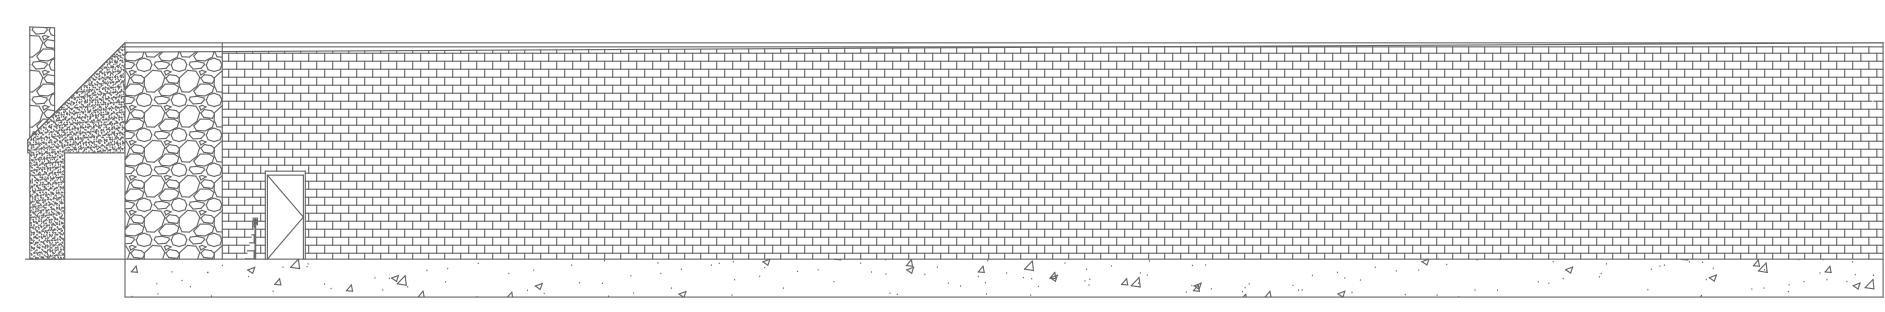


RIGHT EXTERIOR DEMOLITION ELEVATION
SCALE: 1/8"=1'-0"

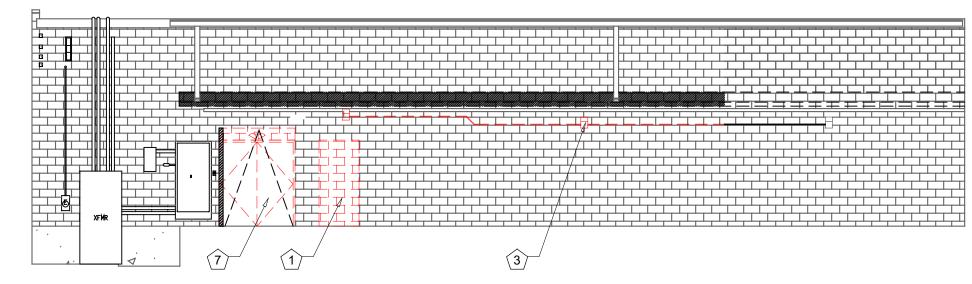

3 REAR EXTERIOR DEMOLITION ELEVATION SCALE: 1/8"=1'-0"

LEGEND

===== EXISTING TO BE REMOVED

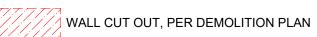

GENERAL NOTES

- A EXISTING CONDITIONS BASED UPON INFORMATION PROVIDED BY OTHERS OR ARCHITECT'S OBSERVATION.
- EXISTING CONSTRUCTION TO REMAIN TO BE PROTECTED AS REQUIRED.

 B REMOVE AND REPLACE DAMAGED CONSTRUCTION DUE TO CONTRACTOR'S ACTIVITIES.
- EXISTING CONSTRUCTION TO BE REWORKED AS REQUIRED FOR INSTALLATION OF NEW CONSTRUCTION. PATCH AND REPAIR EXPOSED C SURFACES OF EXISTING CONSTRUCTION TO REMAIN AT LOCATIONS OF EXISTING CONSTRUCTION TO BE REMOVED. FIELD VERIFY SCOPE OF WORK REQUIRED.
- D NEW CONSTRUCTION TO MATCH EXISTING CONSTRUCTION TYPE AND FINISH, UNLESS OTHERWISE NOTED.

DEMOLITION KEYNOTES

- 1 CUT OPENING IN EXTERIOR WALL, FOR NEW DOOR. REFER TO SHEET A1.2 FOR ADDITIONAL INSTRUCTION.
- EXISTING STOREFRONT TO BE REMOVED AS REQUIRED FOR INSTALLATION OF NEW VESTIBULE. REFER TO SHEET A1.2 FOR ADDITIONAL INSTRUCTION.
- EXISTING EXTERIOR LIGHT FIXTURE INCLUDING CONDUIT CASING TO BE REMOVED. PREPARE WALL AS REQUIRED TO RECEIVE NEW WALLPACK FIXTURE.
- REMOVE SUITE/ADDRESSING AS REQUIRED. REFER TO SHEET A2.2.2 FOR ADDITIONAL INSTRUCTION.
- DEMO ROCK FACE. EXISTING CMU BLOCK TO REMAIN.
- 6 DEMO EXISTING COLUMN.
- DEMO EXISTING OVERHEAD DOOR, CUT AND PREPARE WALL FOR NEW OVERHEAD DOOR.
- 8 DEMO EXISTING CANOPY AND LIGHTING.
- 9 DEMO EXISTING SIGN.
- 10 DEMO EXISTING PARAPET CAP FLASHING.
- 11 DEMO EXISTING METAL ROOF, PREP FOR NEW ROOF PER SECTIONS.





SECTION + DEVENING SPRING SPRI

SNOIL

OLITION ELEV

4E, TX 78006
TEDIOD DEM

S.Reilly 170 Parits


REV. DESCRIPTION DATE

FOR REVIEW XX.XX.XX

DRAWN BY: CHECKED BY:


27/25 CT NUMBER:

A2.2.1

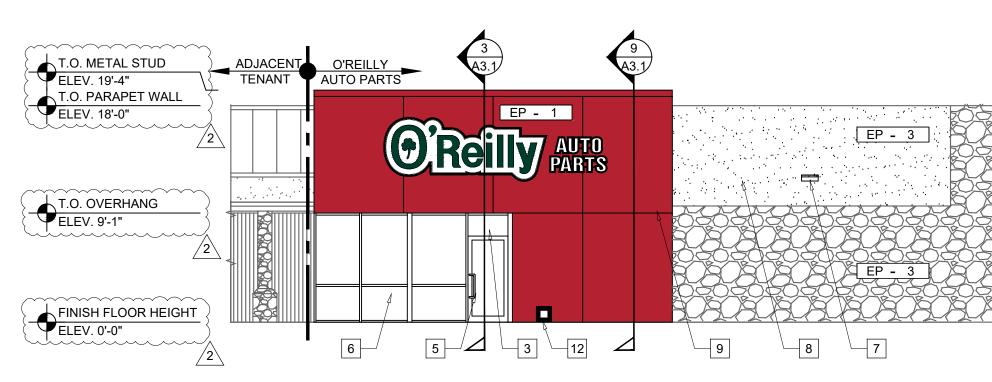


FRONT EXTERIOR ELEVATION

[/] SCALE: 1/8"=1'-0"

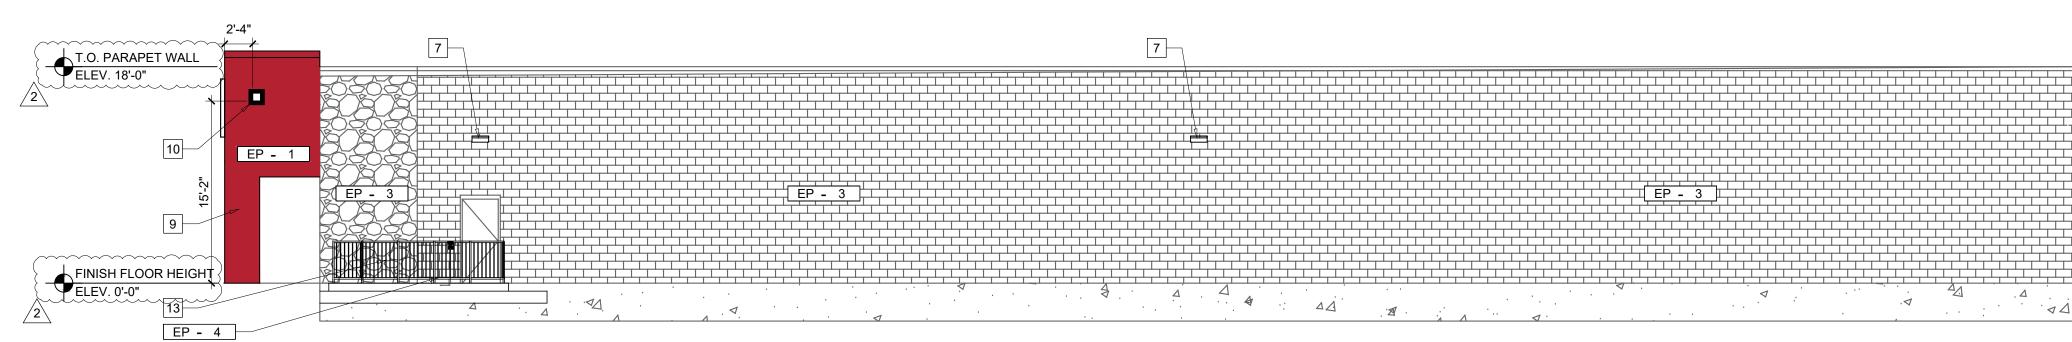

2 RIGHT EXTERIOR ELEVATION
SCALE: 1/8"=1'-0"

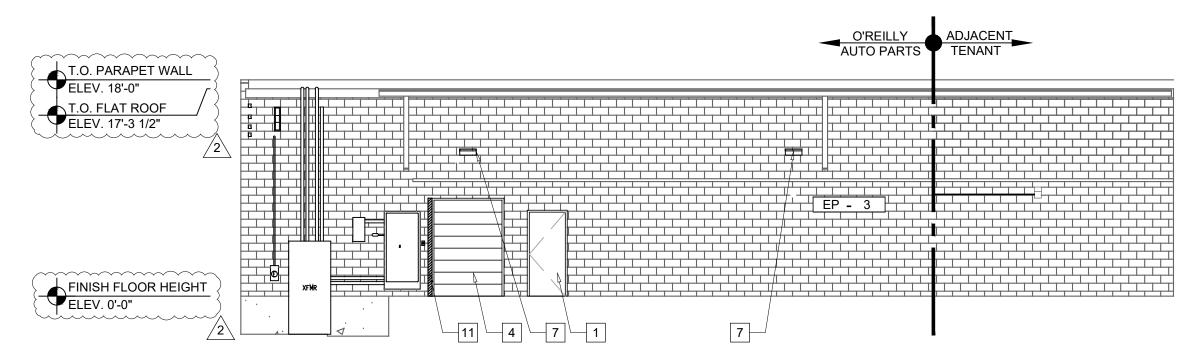

REAR EXTERIOR ELEVATION SCALE: 1/8"=1'-0"

EXTERIOR FINISH SCHEDULE

NOTE: REFER TO ELEVATIONS FOR FINISH LOCATIONS

STEEL DOORS AND FRAMES
MFG: REFER PROJECT MANUAL

FINISH: FACTORY PRIMED AND FIELD PAINTED, SEMI-GLOSS FINISH COLOR: TO MATCH ADJACENT WALL COLOR, SHERWIN WILLIAMS OR APPROVED

NOTES: / B65V105 /

B65C105) CLEAR URETHANE

STOREFRONT SYSTEM
MFG: EFCO, KAWNEER OR VISTA WALL (NO SUBSTITUTES) COLOR: TO MATCH EXISTING or IVY, DARK IVY OR INTERSTATE GREEN, RESPECTIVELY



STYLE: LAYER 1 - NIGHT VISION 15 (APPLY FIRST); LAYER 2 - FASERA, MILANO (APPLY OVER) REP: JIM MANNIX | 612.325.6509

FACADE EP - 1

PAINT		EP - 2	PAINT	
MFR:	SHERWIN WILLIAMS		MFR:	SHERWIN WILLIAMS
STYLE:	SHER-CRYL		COLOR:	SW6141 SOFTER TAN
COLOR:	SW6871 POSITIVE RED		FINISH:	SEMI GLOSS
FINISH:	GLOSS		APP:	PER MFR SPECS FOR
APP:	PER MFR SPECS FOR		A	SURFACE
AI I .	SURFACE			
	INCLUDE THREE			
	COMPONENT (B65T105			

EP - 3 PAINT

EP - 4 PAINT MFR: SHERWIN WILLIAMS COLOR: SW6468 HUNT CLUB FINISH: SEMI GLOSS PER MFR SPECS FOR SURFACE NOTE: NEW RAILING

MFR: SHERWIN WILLIAMS COLOR: SW6108 LATTE FINISH: SEMI GLOSS

PER MFR SPECS FOR SURFACE

EXTERIOR GENERAL NOTES

- MANUFACTURER: SHERWIN WILLIAMS SPECIFIED. EQUAL PRODUCTS BY PPG INDUSTRIES ACCEPTABLE (NO SUBSTITUTES).
- APPLICATION: INSTALL PER MANUFACTURER'S RECOMMENDATIONS FOR PROJECT CONDITIONS. EACH COAT SPECIFIED SHALL BE SPRAY APPLIED AND BACK ROLLED. COVERAGE THICKNESS INDICATED IN WET MIL UNITS, UNLESS OTHERWISE INDICATED.

EXTERIOR KEYNOTES

- NEW HOLLOW METAL DOOR AND FRAME. REFER TO SHEET A6.1 FOR FURTHER INFORMATION.
- SURFACE MOUNTED SIGN, O'REILLY CONSTRUCTION FURNISHED AND INSTALLED. PROVIDE ROUGH-IN ELECTRICAL. GC TO VERIFY ADEQUATE BACKING FOR MOUNTING . COORDINATE REQUIREMENTS WITH O'REILLY CONSTRUCTION. REFER TO SHEET SG2.1 IN SEPARATE EXTERIOR DESIGN
- PREFERRED BUILDING ADDRESS NUMBERS: 6" HIGH HELVETICA WHITE VINYL ADHERED TO EXTERIOR FACE OF GLAZING. CONFIRM WITH LANDLORD/JURISDICTION REQUIREMENTS.
- NEW OVERHEAD DOOR AND FRAME. REFER TO SHEET A6.1 FOR FURTHER
- NEW EXTERIOR STOREFRONT DOOR AND FRAME SYSTEM. REFER TO SHEET A1.2 FOR FURTHER INFORMATION.
- NEW EXTERIOR STOREFRONT GLAZING SYSTEM. REFER TO SHEET A1.2 FOR FURTHER INFORMATION.
- 7 NEW WALLPACK LIGHT FIXTURE. REFER TO ELECTRICAL DRAWINGS.
- PATCH AND REPAIR AFTER REMOVAL OF EXISTING CANOPY. PATCH AND REPAIR ALL MISC. HOLES, RIPS, TEARS, PENETRATIONS, ETC. AS REQUIRED AND MAKE EXTERIOR WEATHERTIGHT.
- CONSTRUCT EIFS PORTAL AROUND STOREFRONT ENTRY.
- 10 OVERFLOW SCUPPER (1) EACH SIDE OF PORTAL.
- 11 INFILL REMAINING PORTION OF OPENING WITH CMU. 12 INTERNAL DOWNSPOUT. SEE WALL SECTION FOR ADDITIONAL INFORMATION.
- NEW COMPOSITE DECKING AND RAILING. REFER TO A1.2 FOR ADDITIONAL INFORMATION.


PRELIMINARY NOT FOR CONSTRUCTION OR PERMIT



ATIONS 닙 TERIOR

FOR REVIEW XX.XX.X ADD 01 03/06/202 01/27/25 ROJECT NUMBER:

EXTERIOR LIGHT FIXTURE SCHEDULE								BACKLIGHT-UPLIGHT-GLARE (BUG) RATING / FULL CUTOFF										=	AUTOMATIC LIGHTING CONTROL												
WILL BE S	UPPLIED BY T DIRECT ORDER	HE "LIGHT FIXTURE SCHEDULE" HE OWNER (O'REILLY). ITEMS RED AND OR RELEASED FROM EQUIPMENT DISTRIBUTOR:	4341 (EONE SOLUT GREEN ASH I CITY, MO 6	DRIVE					SOURCE EMAIL: <u>n</u>	ONE SOLUTI coreilly © sou PHOI	ONS O'REIL rceonesoluti NE: 314-49	LL "LSI MRM" & "XWM" LED FIXTURES HAVE ZERO UPLIGHT AND ARE CONSIDERED FULL CUT FF AND DARKSKY COMPLIANT. THE DELIVERED LUMEN CHART BELOW APPLIES TO "LSI XWM" XTURES AND CONFIRMS THAT IN EVERY CONFIGURATION THE FIXTURE PRODUCES ZERO													COMPLIANCE WITH ENERGY CODE IS ACHIEVED BY: 1. ONCE THE EMS HAS BEEN PROGRAMMED, THE INTERIOR AND EXTERIOR LIGHTS WILL TURN ON AND OFF USING THE FOLLOWING LOGIC: SEE EM SHEETS.					
MOUNTING LAMPS TYPE								ANTITY	UPLIGHT (U = 0). BUG RATING CHART FOR "LSI MRM" FIXTURES IS FOUND ON CORRESPONDING "SP" SHEETS.												INTERIOR WORK LIGHTS WILL TURN ON WITH FIRST MOTION IN THE STORE AND WILL TURN OFF 15 MINUTES AFTER LAST MOTION ONCE THE STORE IS CLOSED.										
	MARK MFR. CATALOG NUMBER VOLTAGE FINISH SO SOLVE SCENT CEILING NOTES NOTES						3	8	DELIVERED LUMENS*								INTERIOR SALES LIGHTS WILL TURN ON AT STORE OPENING AND TURN OFF 15 MINUTES AFTER STORE CLOSING.														
						[품[발						Lumen Distribu	istribution CI	on CRI Delivered		3000K		4000K		Pol	5000K		Wattage	EXTERIOR SIGN LIGHTS WILL TURN ON WHEN ITS DARK ENOUGH							
MARK	MFR.	CATALOG NUMBER	SUPPLY VOLTAGE FINISI	SURF.	[[원]	[동[종]	WATTAGE			NOTES			[[Package		Lumens	Епісасу	BUG Rating	Delivered Lumens		BUG Rating L	uniens	Efficacy BUC	Rating Lu	mens	•	g	OUTSIDE	ANYTIME	DURING STORE HOURS, AND WILL TUR	
LED EVERNAR LIGHTO									03L	2 7	0 2703	120	B1-U0-G1	2822 2873	125	B1-U0-G1 B1-U0-G1	3088	137 B1-	-U0-G1 3 -U0-G1 3	088 137 144 139	7 B1-U0-G1 9 B1-U0-G1	_	STORE								
WS1	LSI	XWM-FT-LED-06L-30-UE-BRZ NO SUBSTITUTIONS	120 DARK BRONZ	EX	x	1	45	FUL ARCHITECTUR	L CUT-OFF	, BUG RAT	TING B1-U0		NS. 1		FT 7	0 2718 0 3546	120 120	B1-U0-G1 B1-U0-G1	2838 3702	126 125	B1-U0-G1 B1-U0-G1		137 B1-	-U0-G1 3 -U0-G1 4	105 137 051 137	7 B1-U0-G1	1	OUTSIDE	AND IT I	GHTS WILL TURN ON WHEN IT IS DARK S WITHIN STORE HOURS OR THERE IS WILL TURN OFF 30 MINUTES AFTER L	MOTION IN
WS2	LSI	XWM-FT-LED-03L-30-UE-BRZ-PCI120	100 DARK		 	1 1	45	FUL	L CUT-OFF	BUG RAT	TING B1-U0)–G1.		04L	3 7	0 3610	122 121	B1-U0-G1	3769 3722	128			140 B1-	-U0-G1 4	124 140			ONCE T	HE STORE	IS CLOSED.	
NO SUBSTITUTIONS 120 BRONZE X X 1 45 ARCHITECTURAL ELEVATIONS SHOW DIMENSIONED LOCATIONS. 120 BRONZE X X 1 45 ARCHITECTURAL ELEVATIONS SHOW DIMENSIONED LOCATIONS. 120 BRONZE X X 1 45 ARCHITECTURAL ELEVATIONS SHOW DIMENSIONED LOCATIONS. 120 BRONZE X X 1 45 ARCHITECTURAL ELEVATIONS SHOW DIMENSIONED LOCATIONS.								NS. '		2 7	0 5274	118	B2-U0-G1	5506	126 123	B2-U0-G2	6025	138 B1- 135 B2-	-U0-G1 4	073 138 025 138			FOR NE	W CONSTR	RUCTION LOCATIONS ONLY, THERE IS A RAM TO KEEP SIGN AND SITE LIGHTS	ON LINTH					
FIXTURE GUARTITY TO BE VERIFIED WITH SITE PLAN GUARTITY								<u> </u>	06L	3 7	0 5369	120	B1-U0-G1	5606	125 124	B1-U0-G1	6134	137 B1-	-U0-G2 6	134 137 058 136			MIDNIGH	T RATHER	THAN THE TIMES INDICATED ABOVE. O	O'REILLY					
									T	OTAL	LUM	ENS:		\leftarrow	2 7	0 6996	113	B2-U0-G2	7304	118	B2-U0-G2	7993	129 B2-	·U0-G2 7	993 129					S PROGRAM ONE YEAR AFTER STORE (
								\ \ \ \ \ \ \ \ \ \ \ \ \ \ \ \ \ \ \	S1: 5536 L	UMENS				08L _	3 7 FT 7		115 113	B1-U0-G2 B1-U0-G2			32-U0-G2	8037			138 131 037 130	1 B2-U0-G2 0 B2-U0-G2	_		ING TX, E Y PURPOS	EXTERIOR LIGHTS STAY ON OVERNIGHT SES.)	FOR
								AS		MENS OF I	LIGHT POLES			12L	2 70		103	B2-U0-G2 B2-U0-G2				12014	118 B3-		2014 118 2232 120	8 B3-U0-G3 0 B2-U0-G2	102.2	2. <u>RESTROC</u>	DMS AND	OFFICES: ALL LIGHTING IN THESE AREA	AS ARE
								\wedge			000 LUMENS			(FT 7	0 10574	103	B2-U0-G3	11040	108	32-U0-G3 1	12080	118 B2-	·U0-G3 12	2080 118	8 B2-U0-G3	3				
								<u>//</u> } TO	TAL AREA:	4.72 ACRE	ES)																	
								(2,282 LUME)																	
									~~~	~~~																					
			~~~~	~~~	~~	<b>~~</b>	~~~	<b>~~~</b>	<b>~~~</b>	~~~	~~~	~~~	~~	~~	<b>~~</b>	~~~	<b>~~</b>	~~	<b>~~</b>	<b>~~~</b>	~~~	<b>~~</b>	~~	<b>~~</b>	<b>~~~</b>	~~~	~~~	· · · · · · · · · · · · · · · · · · ·	~~~	······································	~~~
		(2.2	0.0	•	0 0		•	0.0	0.0	0.0	0.4		0.0	0.0	0.0	0.0	•	0.0	0.0	0.0	0.0	0.0	0.0	0.0	
		(+0.0	+0.0	+0.	.0 +0.	0 +0	U	+0.0	+0.0	+0.0	+0.0	+	_0.0	+0.0	+0.0	+0.0	-	+0.0	+0.0	+0.0	+0.0	+0.0	+0.0	₊ 0.0	
		(PROF	ERTY LIN	E —													
		(_0.0	0.0	0	.0 0.	0 0	0	0.0	0.0	0.0	0.0	, \	0.0	0.0	0.0	0.0	0	0.0	0.0	0.0	0.0	0.0	0.0	0.0	

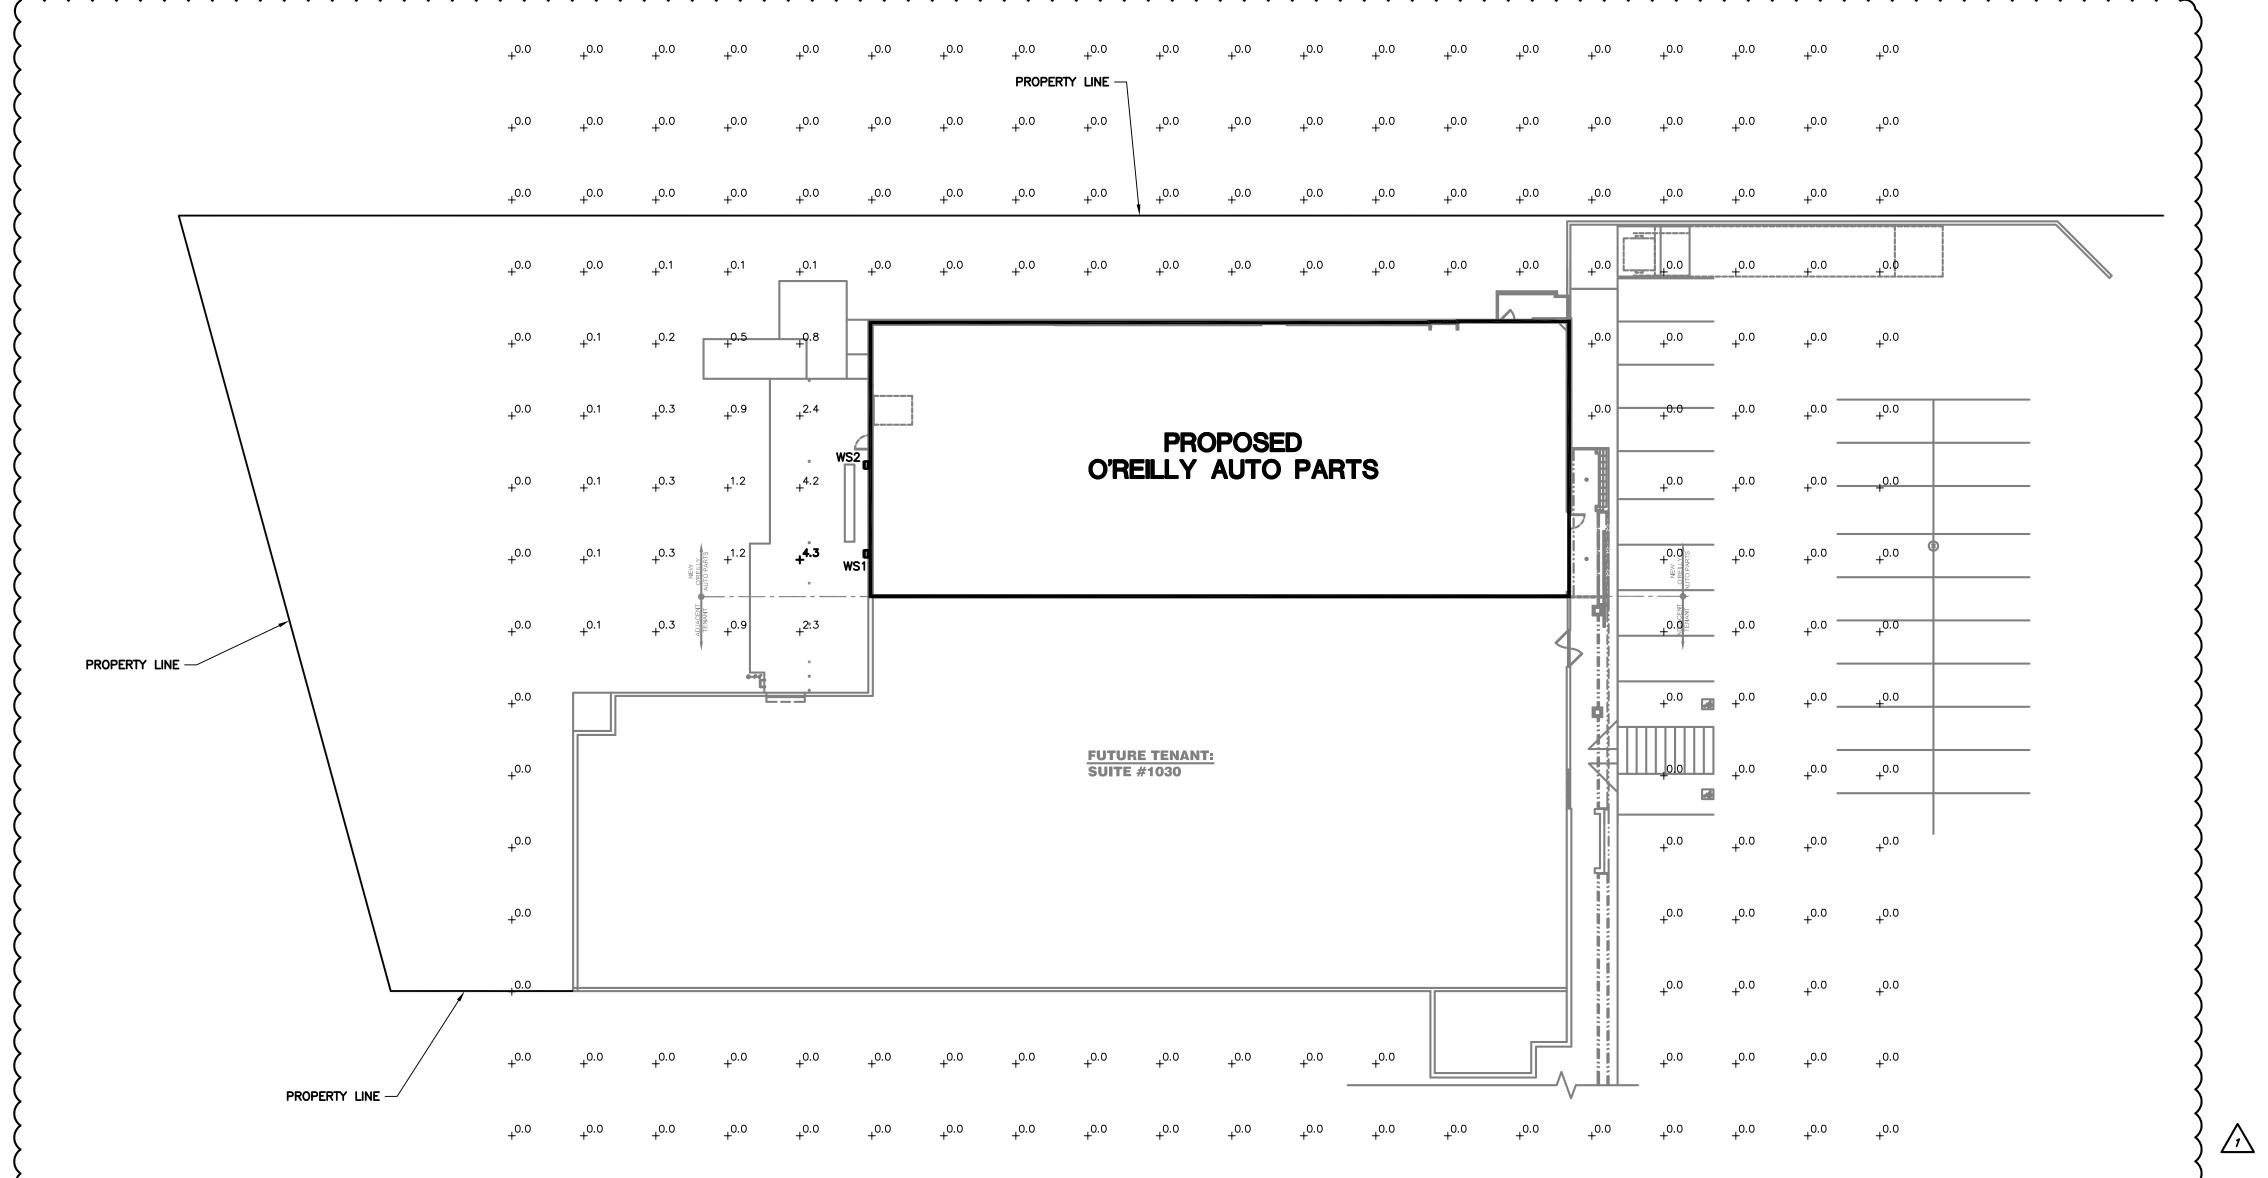





DATE SIGNED: 03.06.2025

ENGINEER OF RECORD
RYAN S. JONES

ENGINEER LICENSE NUMBER
121461

SHEETS BEARING THIS SEAL ARE
AUTHENTICATED, RESPONSIBILITY FOR
ALL OTHER PLANS, SPECIFICATIONS
OR INSTRUMENTS ARE DISCLAIMED.

rfield Boulevard, Suite 200, Springfield, MO

Engineering | Energy | Inr 2225 West Chesterfield Boulevard, Suite 200, S P: 417.877.1700 www.cj

SITE LIGHTING PHOTOMETRICS

O'REILLY AUTO PA 1032 N MAIN BOERNE, TX 78006



REV.	DESCRIPTION	DATE
\bigwedge	ADDENDUM #1	03.06.2025

DRAWN BY: JBR

DATE: 01.27.2025 PROJECT NUMBER: 24308

SP 1